


SECTION A-A
1:100

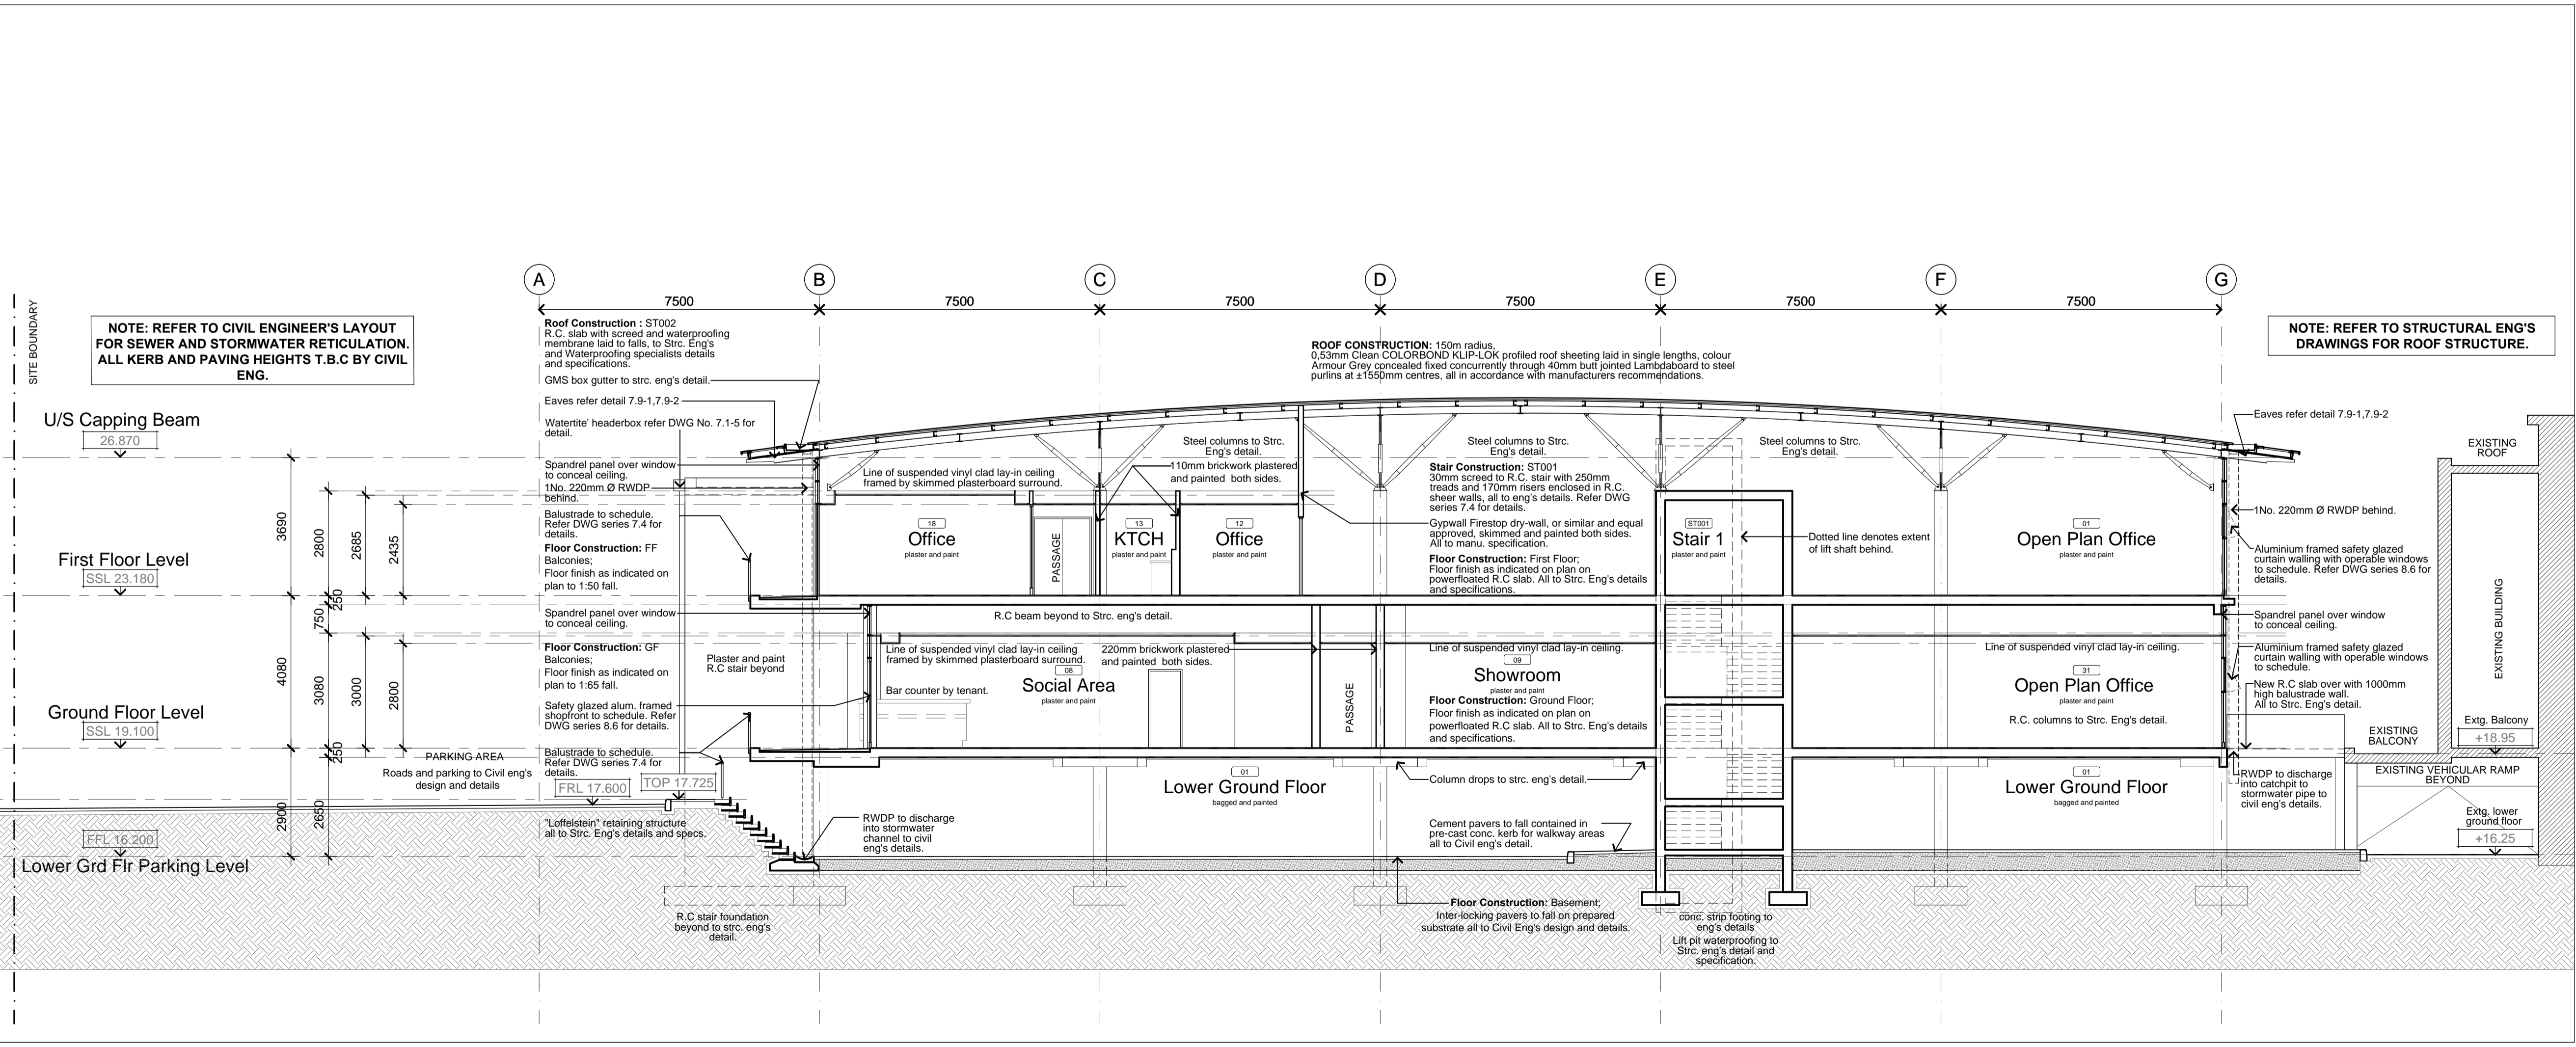

SECTION B-B
1:100

- Read in conjunction with Drawing Numbers.**
- 3969 - 2-01B Basement Parking
 - 3969 - 2-00 Ground Floor Plan
 - 3969 - 2-01 First Floor Plan
 - 3969 - 2-02 Roof Plan
 - 3969 - 4-00 North & South Elevations
 - 3969 - 4-01 East & West Elevations

and all relevant Structural, Mechanical, Electrical, Civil and Fire Consultants drawings and specifications.
All dimensions and levels to be verified before commencement of work and any discrepancies to be reported to the Architect.

AS BUILT

client **REDEFINE PROPERTIES**
We're not landlords. We're people.

architect **KIVI ARCHITECTS**
INSPIRING SINCE 1972
116 VOOFF STREET CAPE TOWN BOUL. TEL: 021423 4141 FAX: 021 4231598 email: info@kivi.co.za

workstage **4.2 - TECHNICAL DOCUMENTATION**

project name **EAGLE PARK : New premises for Nashua by Redefine**
BOSMANSDAM ROAD, MILNERTON
ERF No. 29922

| | | | | | |
|----------------|-------------|-------|---------|-------------|----------|
| drawing name | project no. | | | | |
| SECTIONS AA/BB | 3969 | | | | |
| date | scale | drawn | checked | drawing no. | revision |
| 2013.09.02 | 1:100@A1 | SM | SH/NB | 3-00 | |