


**Read in conjunction with Drawing Numbers.**

- 3969 - 2-01B Basement Parking
- 3969 - 2-00 Ground Floor Plan
- 3969 - 2-01 First Floor Plan
- 3969 - 2-02 Roof and Eaves Plan
- 3969 - 3-00 Sections A.A. and B.B.
- 3969 - 4-01 East & West Elevations
- 3969 - 7.9-1/2 Roof Assembly Details

and all relevant Structural, Mechanical, Electrical, Civil and Fire Consultants drawings + specifications.  
All dimensions + levels to be verified before commencement of work and any discrepancies to be reported to the Architect.


**GENERAL NOTES:**

Roof sheeting, cladding, flashings and insulation all fixed strictly in accordance with manufacturers specifications and recommendations.  
Selected roofing sub-contractor to provide shop drawings to Architects and Structural Engineers prior to commencement of any works or procurement of material, refer Roof and Eaves Plan for full specification.

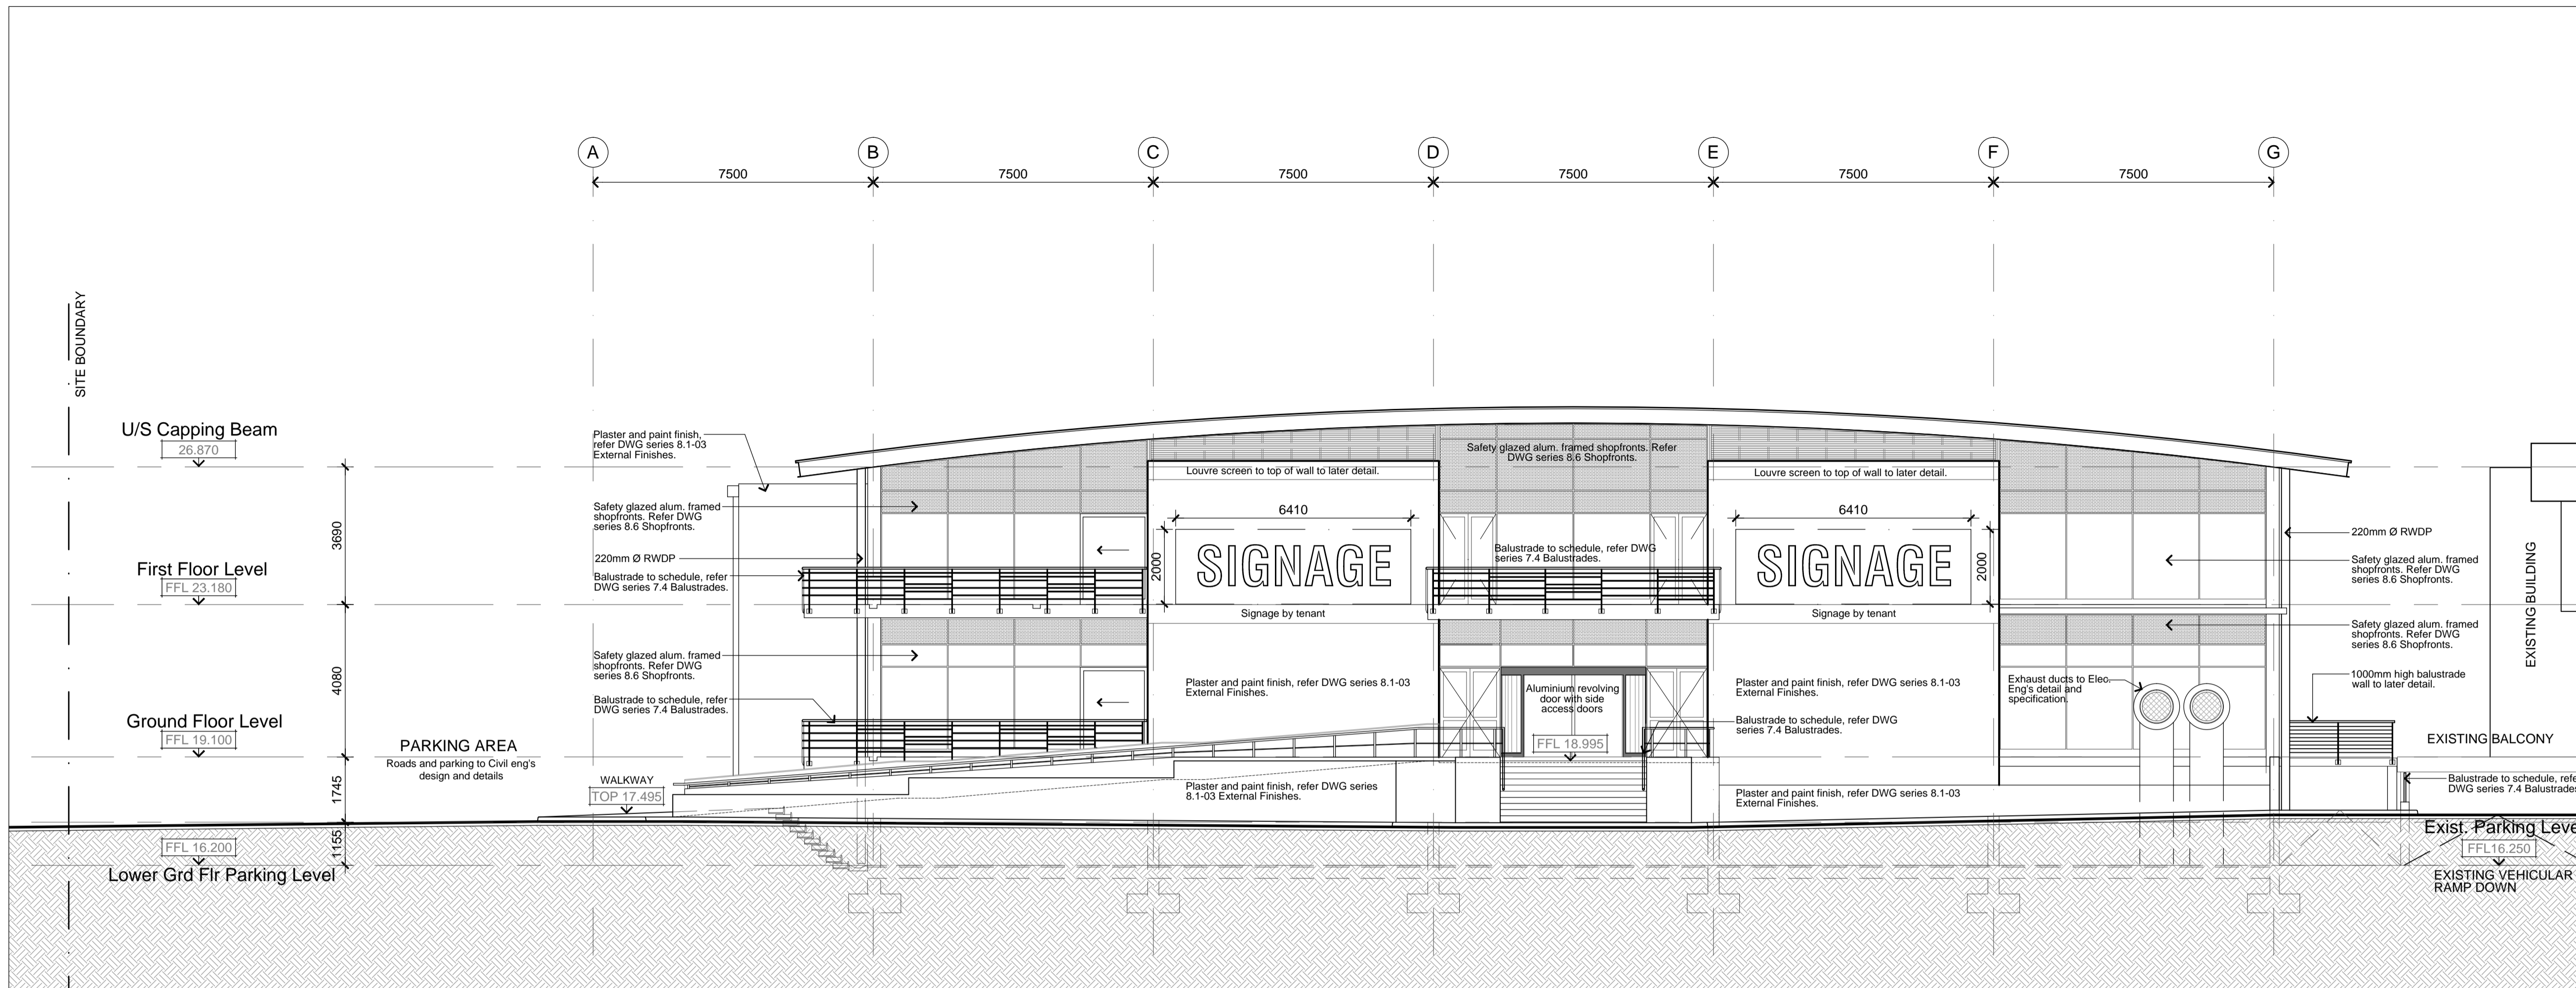

**SOUTH ELEVATION**

1:100

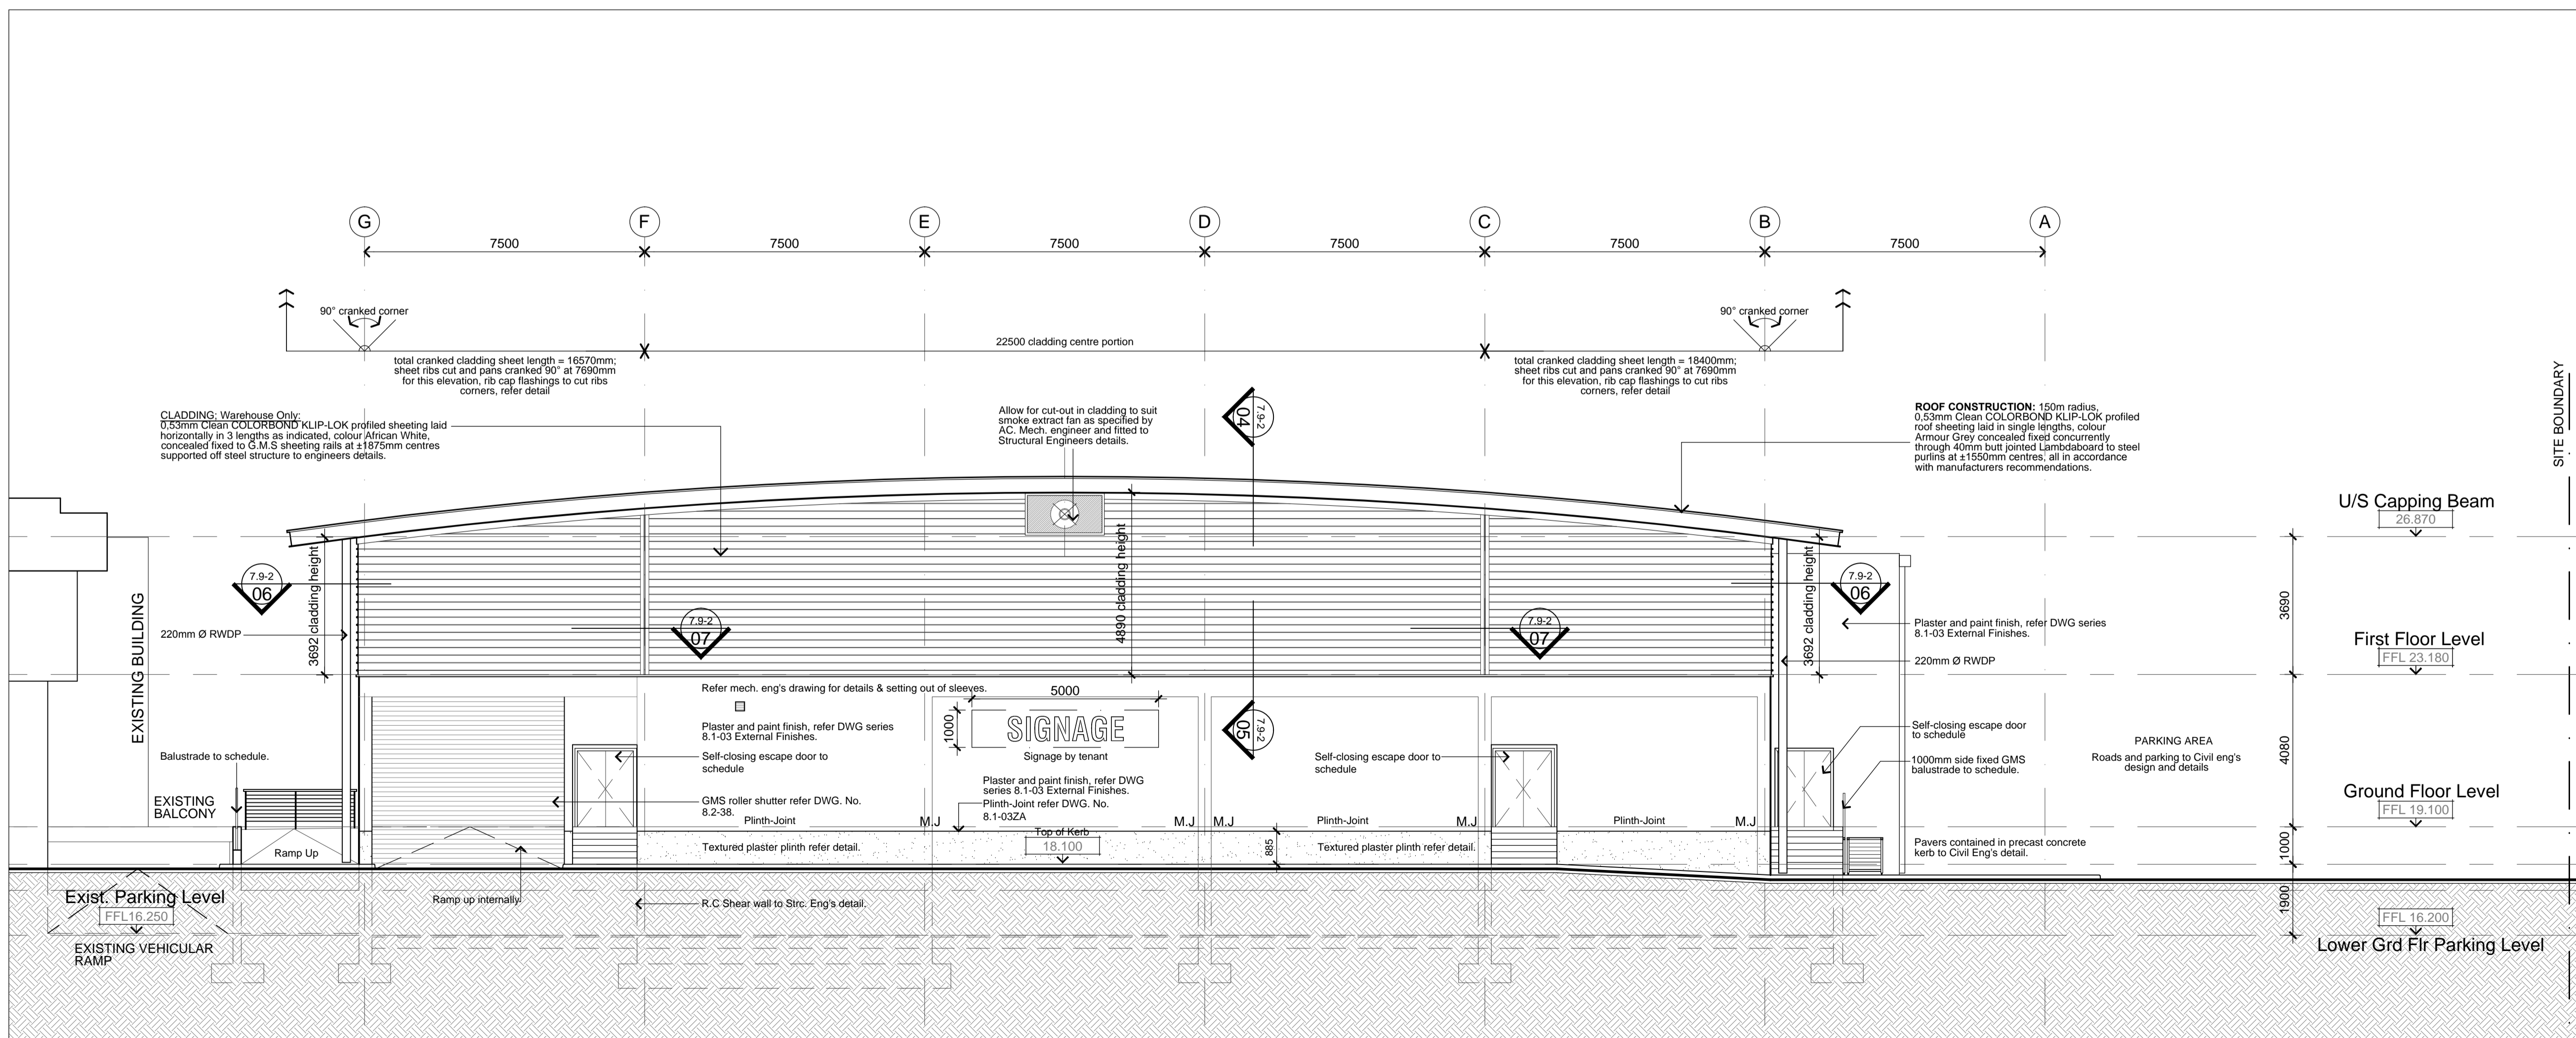

**NORTH ELEVATION**

1:100

<b>AS BUILT</b>			
client	<b>REDEFINE PROPERTIES</b> <small>We're not landlords. We're people.</small>		
architect	<b>KIM H ARCHITECTS</b> <small>ARCHITECTURE + INTERIOR DESIGN</small>		
workstage	4.2 - CONSTRUCTION DOCUMENTATION		
project name	EAGLE PARK BOSMANSDAM ROAD, MILNERTON ERF No. 29922		
drawing name	NORTH & SOUTH ELEVATIONS		project no. <b>3969</b>
date	scale	drawn	checked
2013.09.02	1:100@A1	PP	SH
			drawing no. <b>4-00</b>
			revision