

EAST ELEVATION

1:100

Read in conjunction with Drawing Numbers.


- 3969 - 2-01B Basement Parking
- 3969 - 2-00 Ground Floor Plan
- 3969 - 2-01 First Floor Plan
- 3969 - 2-02 Roof and Eaves Plan
- 3969 - 3-00 Sections A.A. and B.B.
- 3969 - 4-00 North and South Elevations
- 3969 - 7.9-1/2 Roof Assembly Details

and all relevant Structural, Mechanical, Electrical, Civil and Fire Consultants drawings + specifications.

All dimensions + levels to be verified before commencement of work and any discrepancies to be reported to the Architect.

GENERAL NOTES:
Roof sheeting, cladding, flashings and insulation all fixed strictly in accordance with manufacturers specifications and recommendations.

Selected roofing sub-contractor to provide shop drawings to Architects and Structural Engineers prior to commencement of any works or procurement of material, refer Roof and Eaves Plan for full specification.

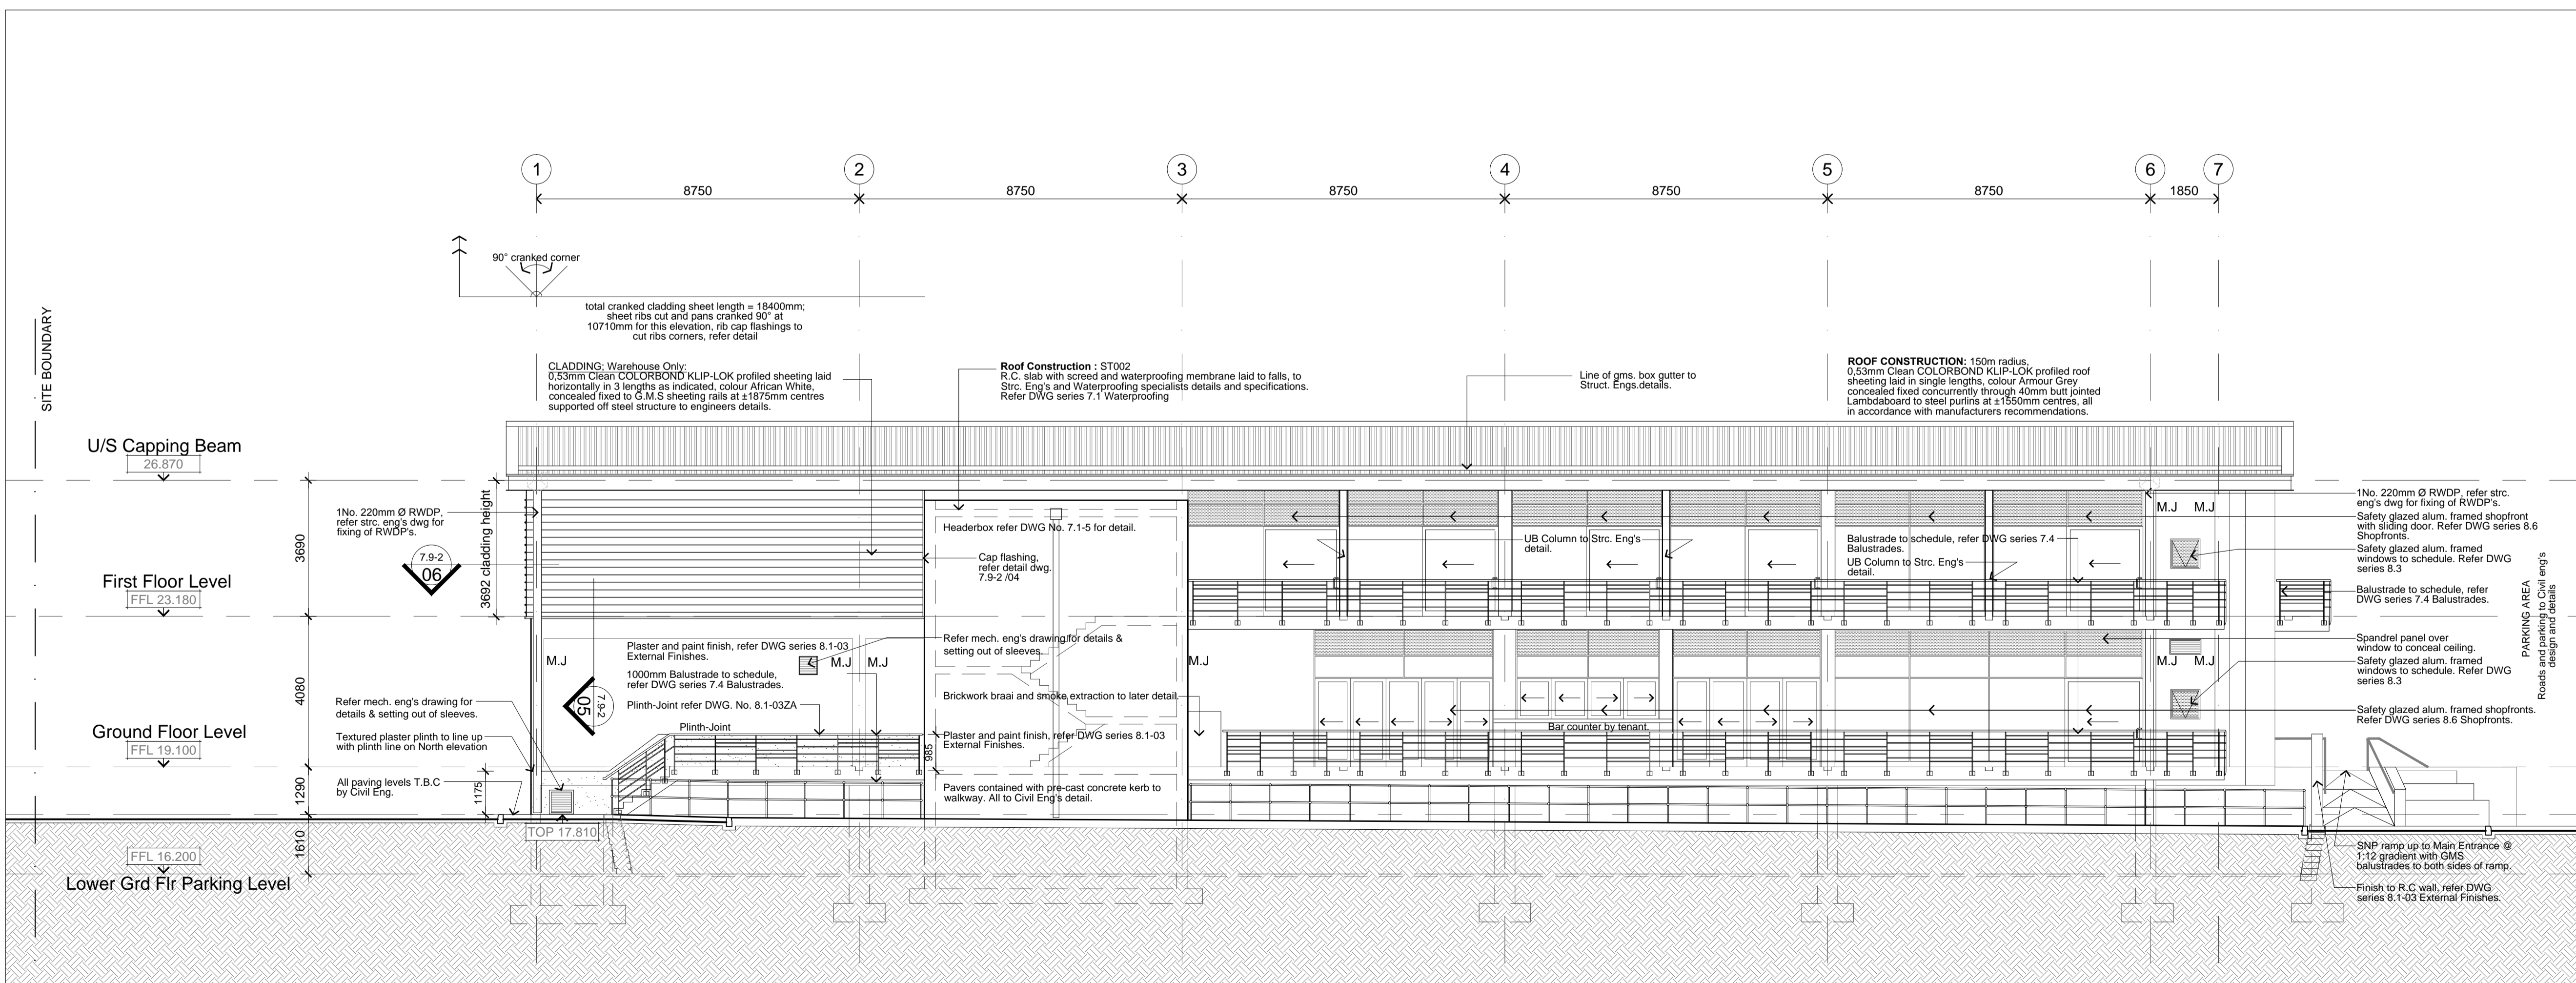

WEST ELEVATION

1:100

AS BUILT

client		Redefine PROPERTIES We're not landlords. We're people.	
architect		KMM ARCHITECTS ARCHITECTURE - INTERIOR DESIGN 114, LUDF STREET, CAPE TOWN 8001 TEL: 021 423 4141 FAX: 021 424 1398 @KMM ARCHITECTS.CO.ZA	
workstage		4.2 - CONSTRUCTION DOCUMENTATION	
project name		EAGLE PARK BOSMANSROAD, MILNERTON ERF No. 29922	
drawing name		EAST & WEST ELEVATIONS	
project no.		3969	
date	scale	drawn	checked
2013.09.02	1:100@A1	PP	SH
drawing no.		revision	
4-01			